

FURNESS S.B. CO. LTD

Nº 344

STEAM TANKER


'EMPIRE GRENADE'

PROFILE & DECK
PLANS

AS BUILT

MIDDLESBROUGH REPAIRS

N.N. "FICUS"

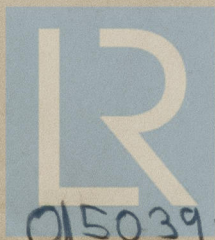

© 2021

Lloyd's Register


015039-015053-0002

341-2-3-4 No 344

PROFILE & DECK PLAN.

DIMENSIONS LENGTH BP 475'0" BREADTH M^o 68'0" DEPTH M^o 36'0"

SCALE 1/8" = 1 FOOT

 

FURNESS S.B.C. LTD

N: 344.

STEAM TANKER

"EMPIRE GRENADIER"

MIDSHIP SECTION

AS BUILT

MIDDLESBROUGH REPORT

N:

N.N. "FICUS"



© 2021

Lloyd's Register

015039-015053-0001

MIDSHIP SECTION. 341-2-3-4. No 344

LENGTH B.P. 475'-0" . BREADTH MLD. : 68'-0" . DEPTH MLD. 36'-0"

SCALE - 2" = 1 FOOT









SHEER OF 5'-0" FOR 2'-0" AFT. (STANDARD CURVE)
25'-0" LOAD DRAFT (ASSUMING STANDARD SHEER 2'-7" FOR 4'-9 1/2" AFT.)

STEAMER PLATE PROPOSED 87 1/2 FROM WITHIN
POOP DECK 1/2" FOR 1/2" AT 44' ALONG
BUTTS QUINQUE FOR 1/2" TO QUADRUPE & THERE AT ENDS
FOR SPACES 4 DIAS. IN QUAD. BUTTS 3/4 DIAS. IN TRIPLE BUTTS
4" - QUINQUE BUTTS

DECK BUTTS IN WAY OF OR. TRIPLE RIVETED JOINTS BY
BEYOND. RIVETS IN BUTTS & BEAMS SPACED 4 DIAS. OVER
68 & 34 DIAS. UNDER - 50 THICKNESS

DECK LONGITUDINALS 8" x 3/4" 15' B.A. (AT 3'-6" SPACING) BUTTS SPACED 8 DIAS.

NOTE - HATCH COVERS NOT IN LINE (SEE DECK PLAN)

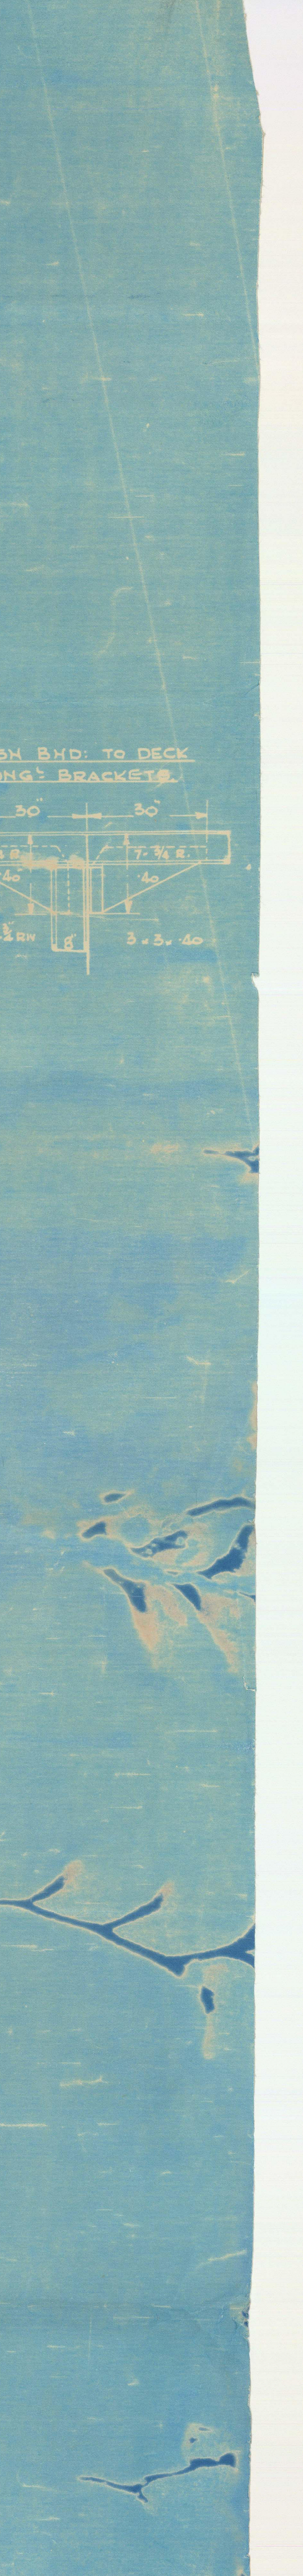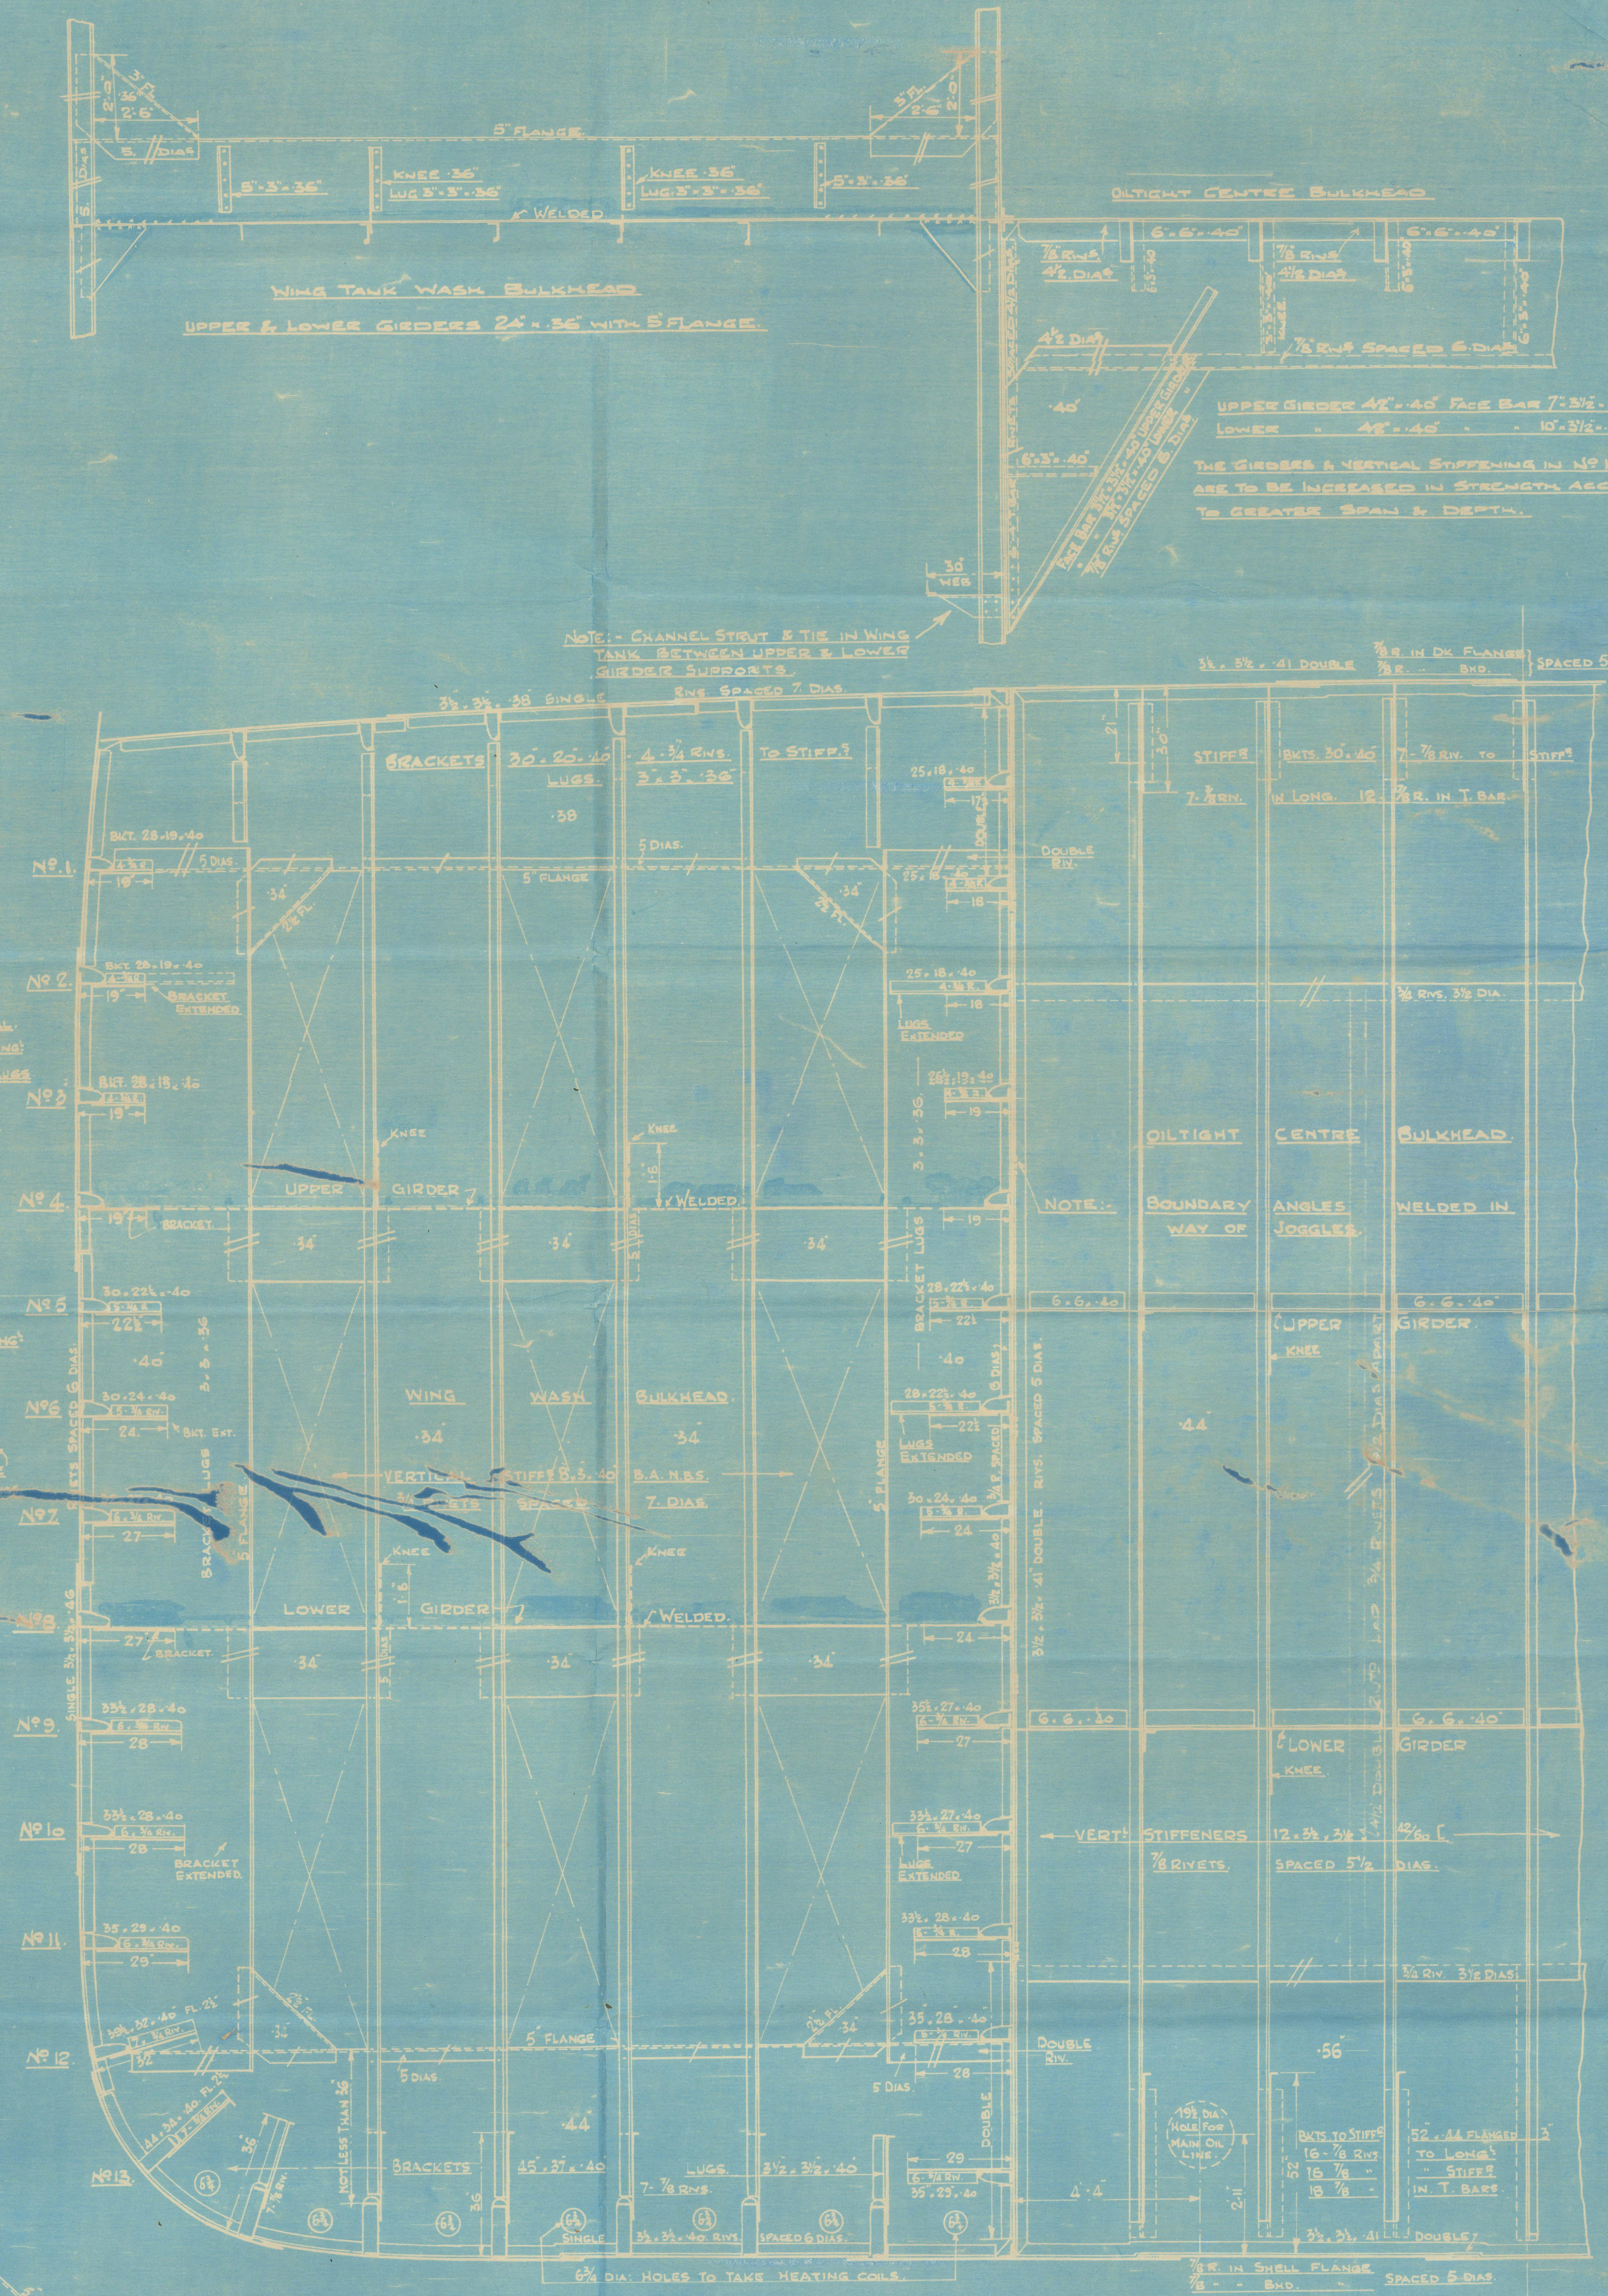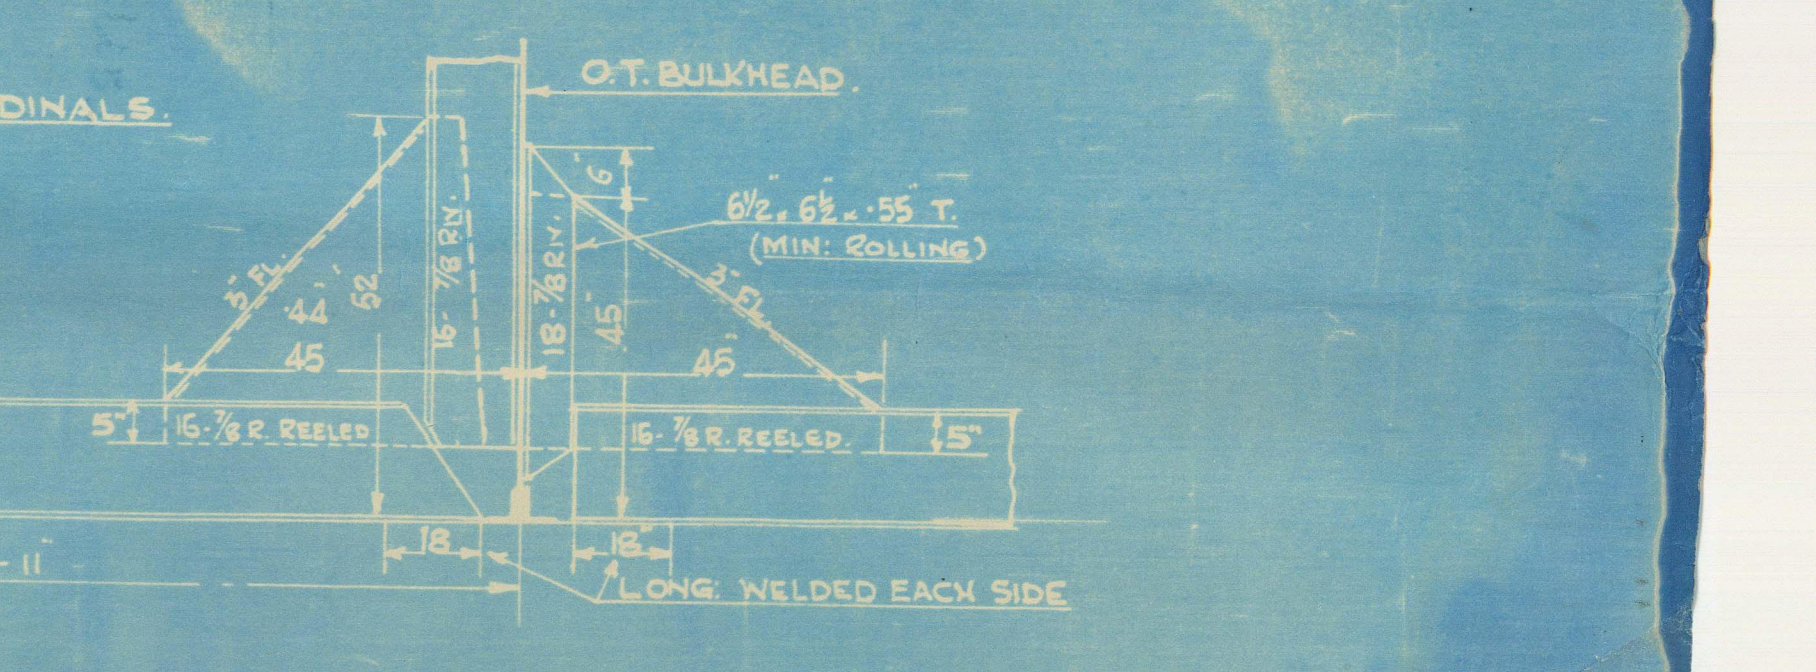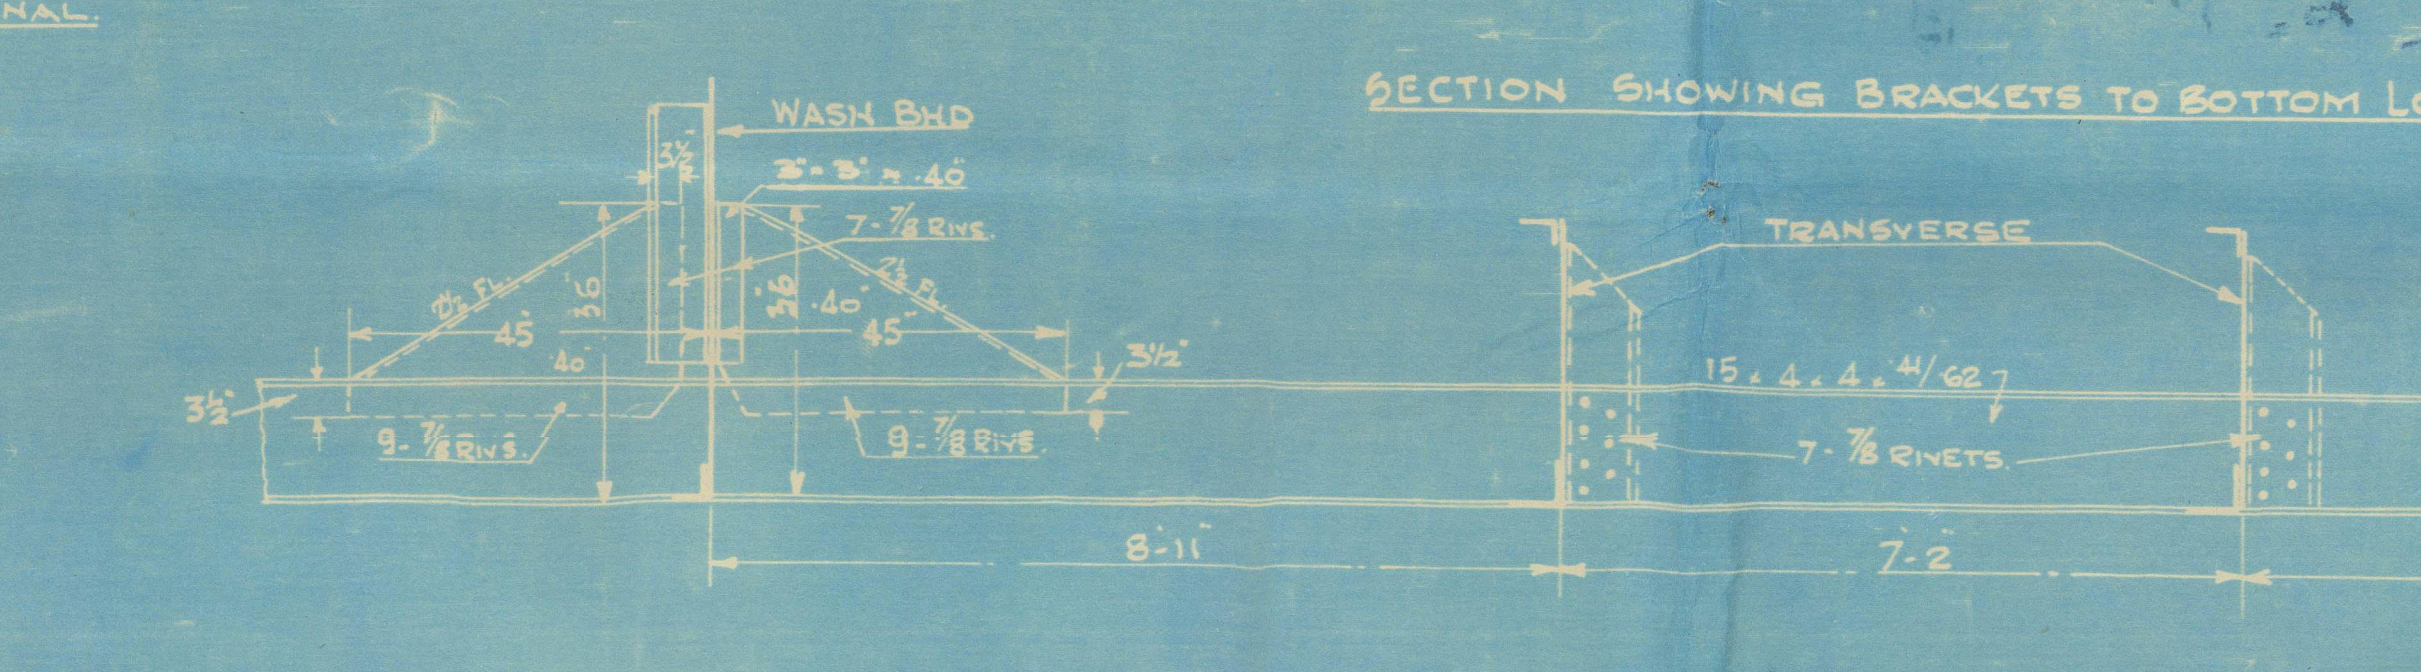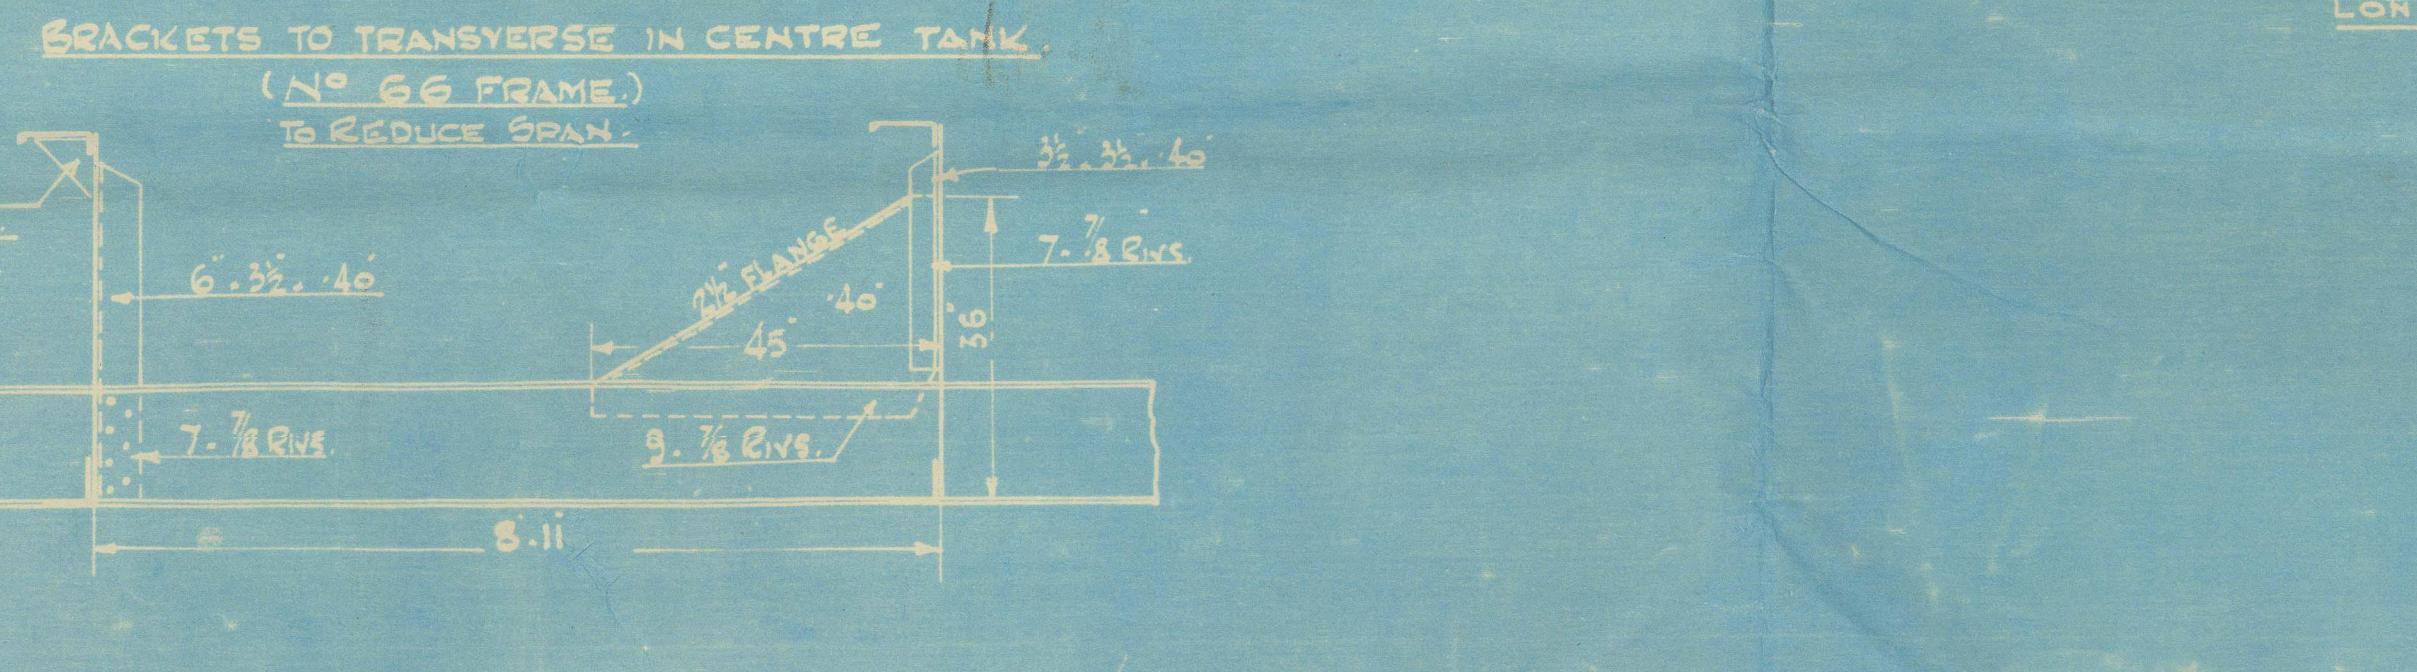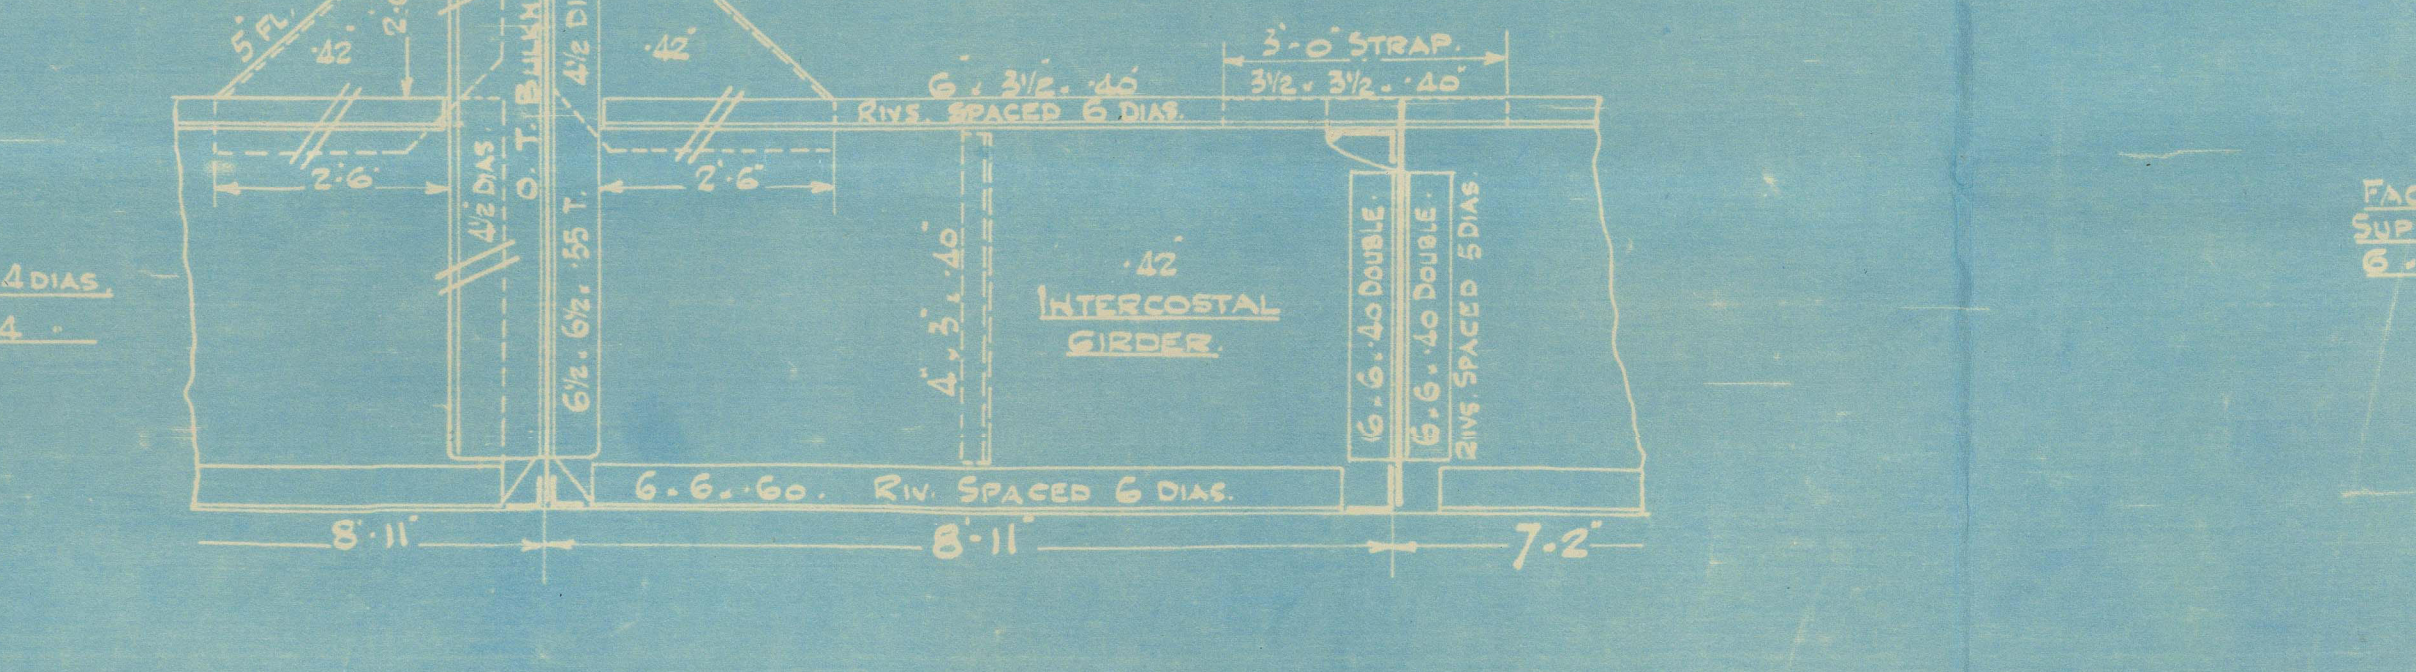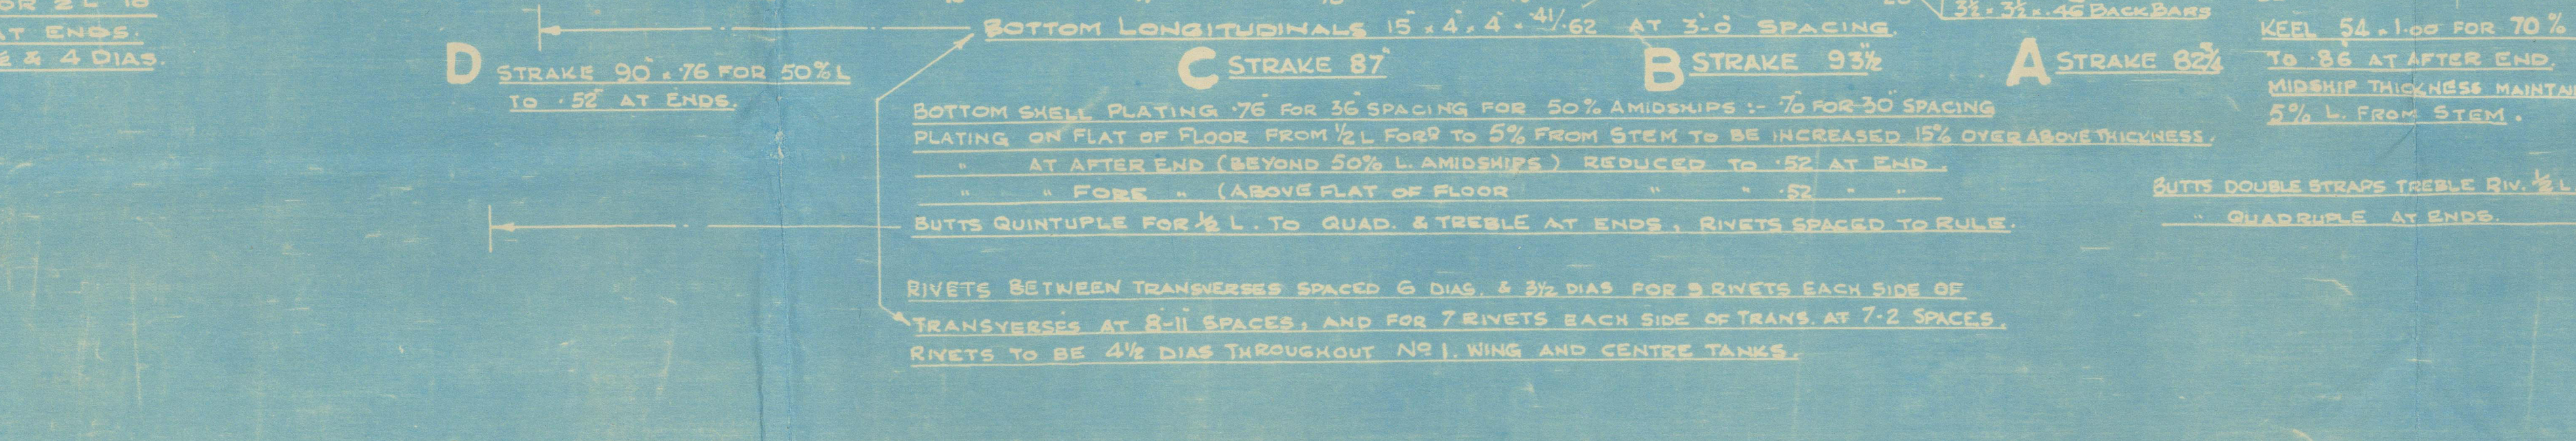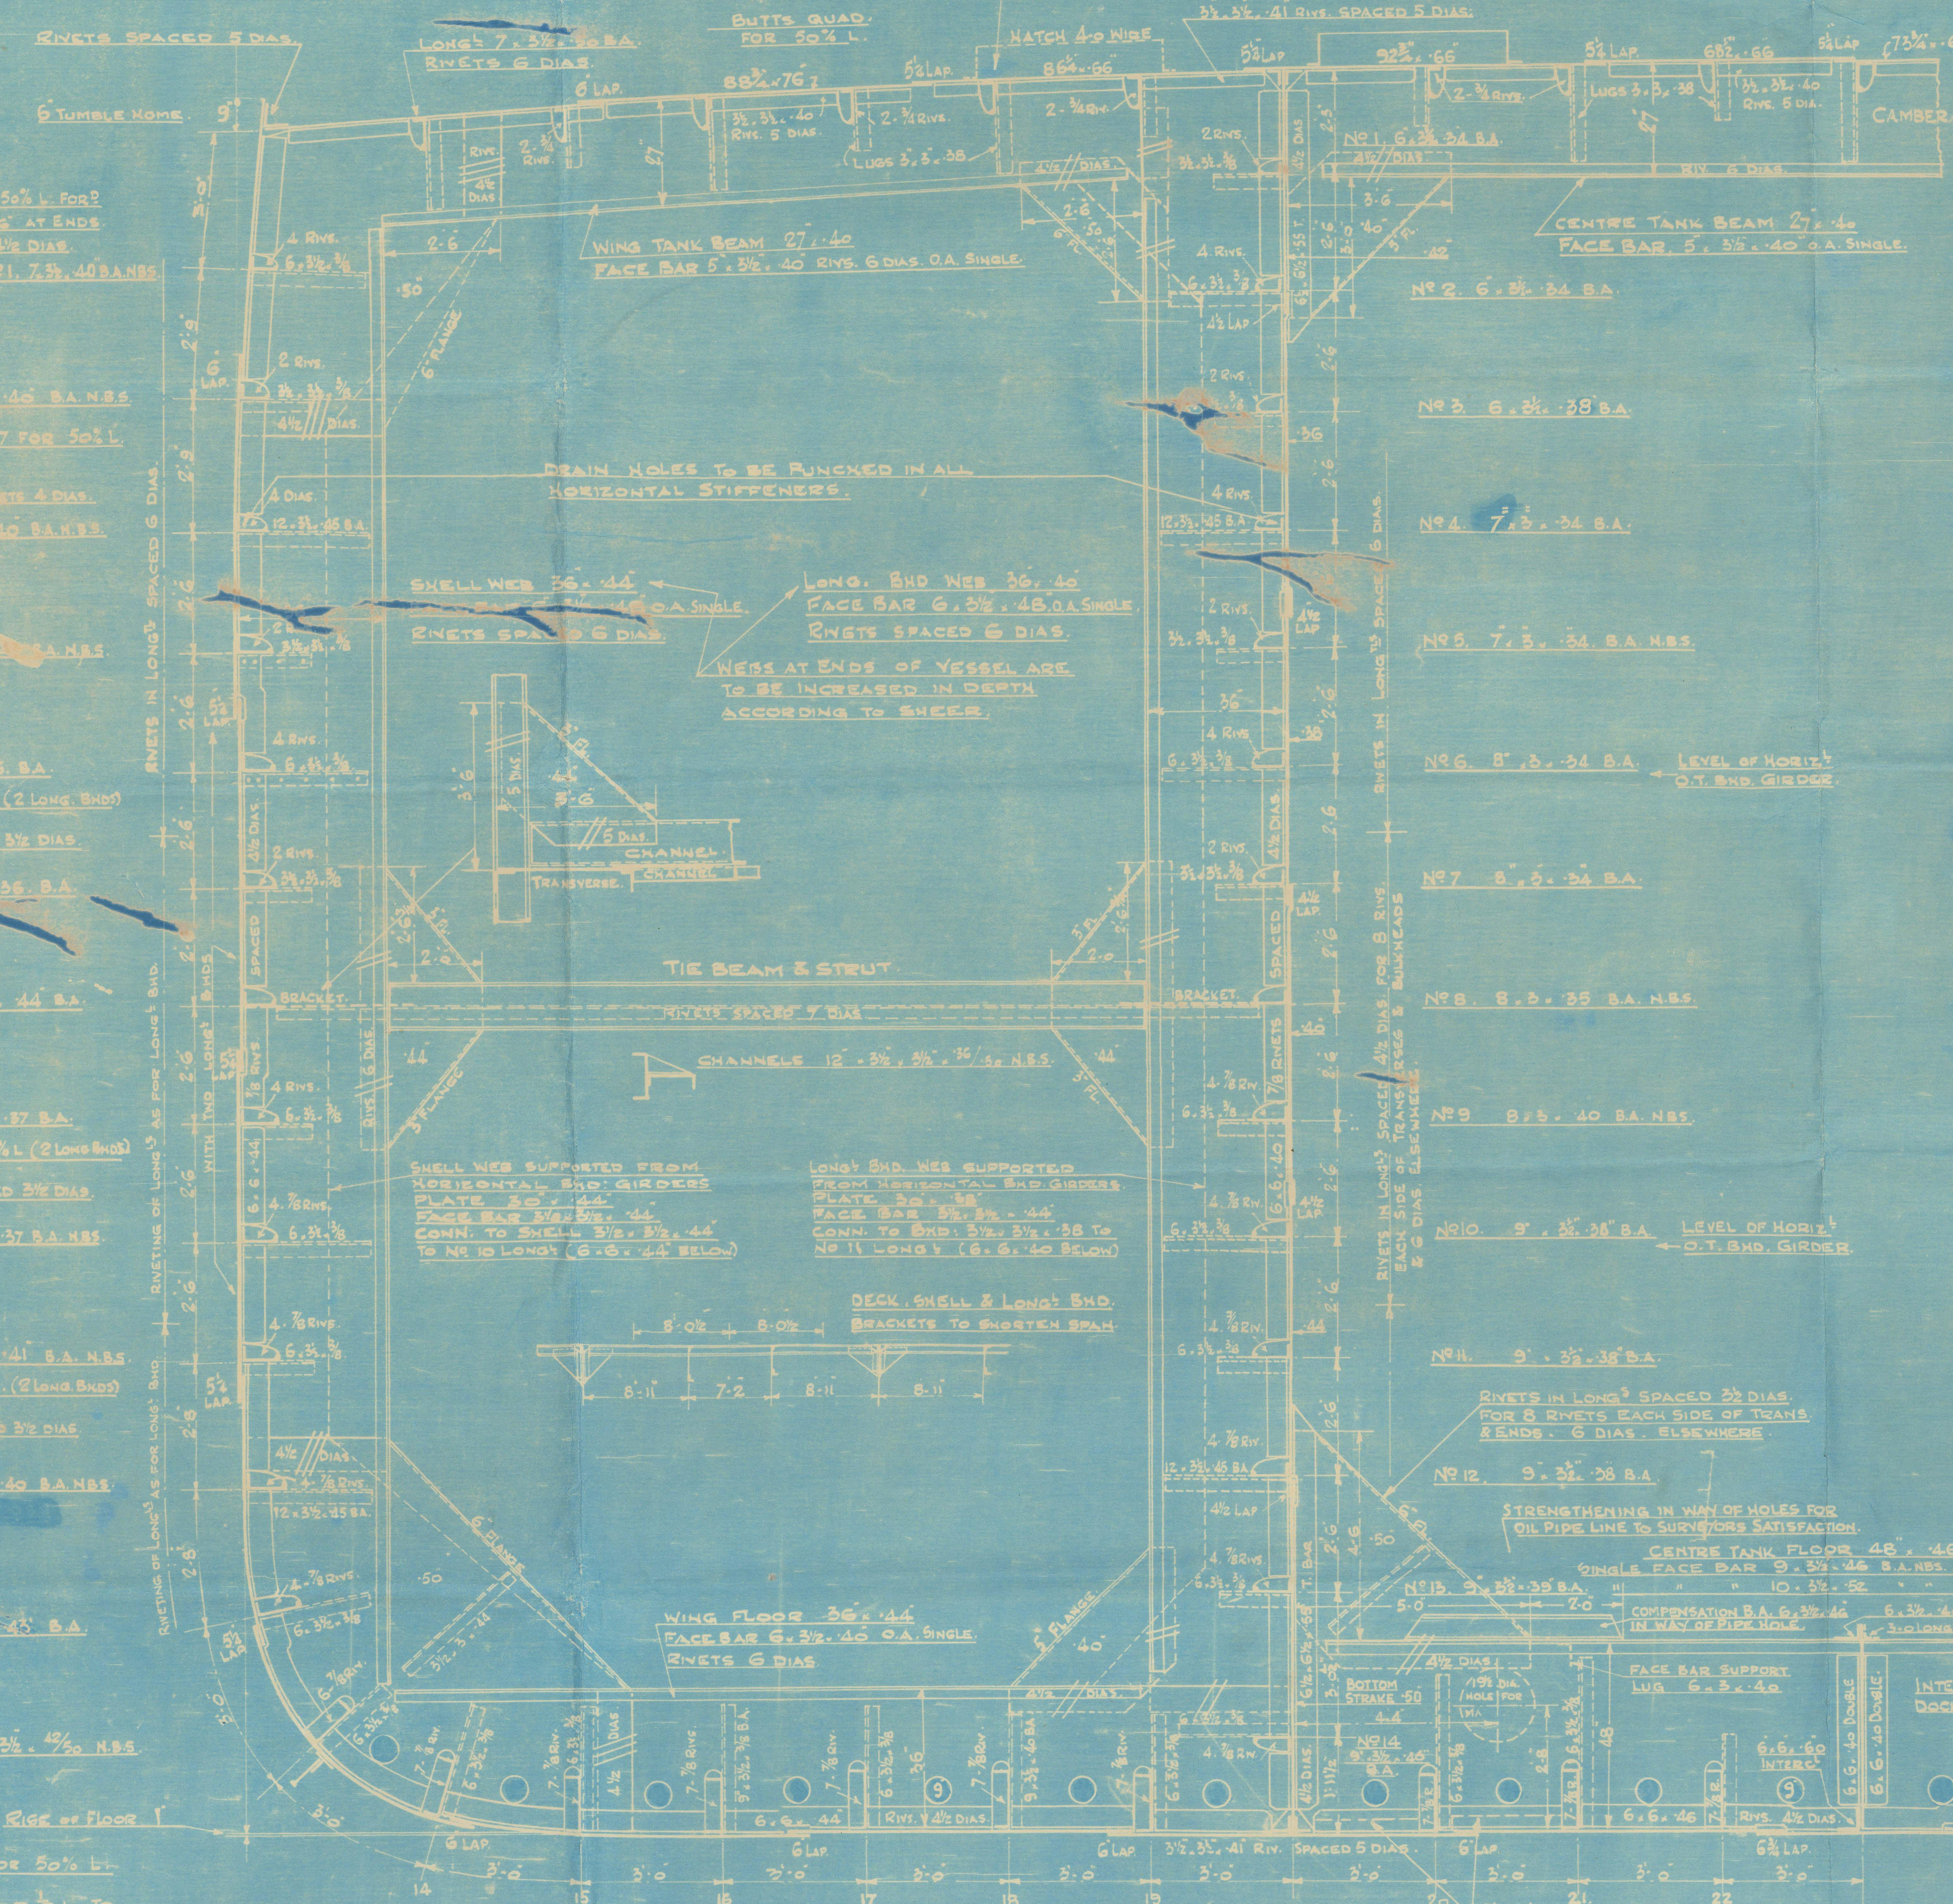

STERN FRAME
V RUDDER

(3)

FURNESS SBCOL

341.234-49.50

S.S. "Empire Dickens"

MDB. RPT. No. 17239

S.S. Empire Norseman

MDB. RPT. No. 17276

S.S. Empire Lyttora

MDB. RPT. No. 17323

S.S. Empire Grenadier

MDB. RPT. No. 17347



S.S. Empire Nugget

MDB. RPT. No. 17375

S.S. Empire Cobbett.

MDB. RPT. No. 17400 'San Wilfrido'

RECORDS DEPT.
LONDON.

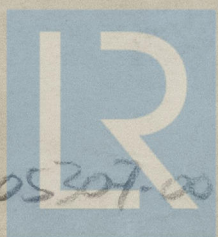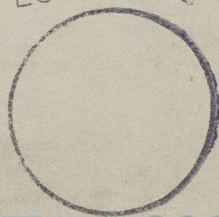

© 2021

Lloyd's Register
Foundation

005307-005310-0001

